

KITCHEN AS-BUILT DOOR SCHEDULE						
KEY	DESCRIPTION	HEIGHT	HINGE SIDE	TYPE	NOTES	QNTY
D01	EXT. HINGED-SLAB	90"	R	HINGED		1
D02	EXT. HINGED-1506 FRENCH	90"	R	HINGED		1
D04	FRAMED OPENING	90"		DOORWAY		3
D05	HINGED-DOOR P03	90"	R	HINGED		2
D06	HINGED-DOOR P03	90"	L	HINGED		3


KITCHEN AS-BUILT WINDOW SCHEDULE						
KEY	DESCRIPTION	HEIGHT	SIZE	TYPE	NOTES	QNTY
W01	DOUBLE HUNG	66"	3056DH	DOUBLE HUNG	66" H; 24" AFF	2
W02	FIXED GLASS	42"	3936FX	FIXED GLASS	42" H; 48" AFF	1
W03	BAY WINDOW UNIT	48"	6140		48" X 20.5"; 42" AFF	1

NOTES

AREA OF DESIGN

*ALL DOORS AND OPENINGS ON THIS LEVEL ARE 90" AFF TO TOP

*TYPICAL CEILING HEIGHT ON THIS LEVEL = 120"

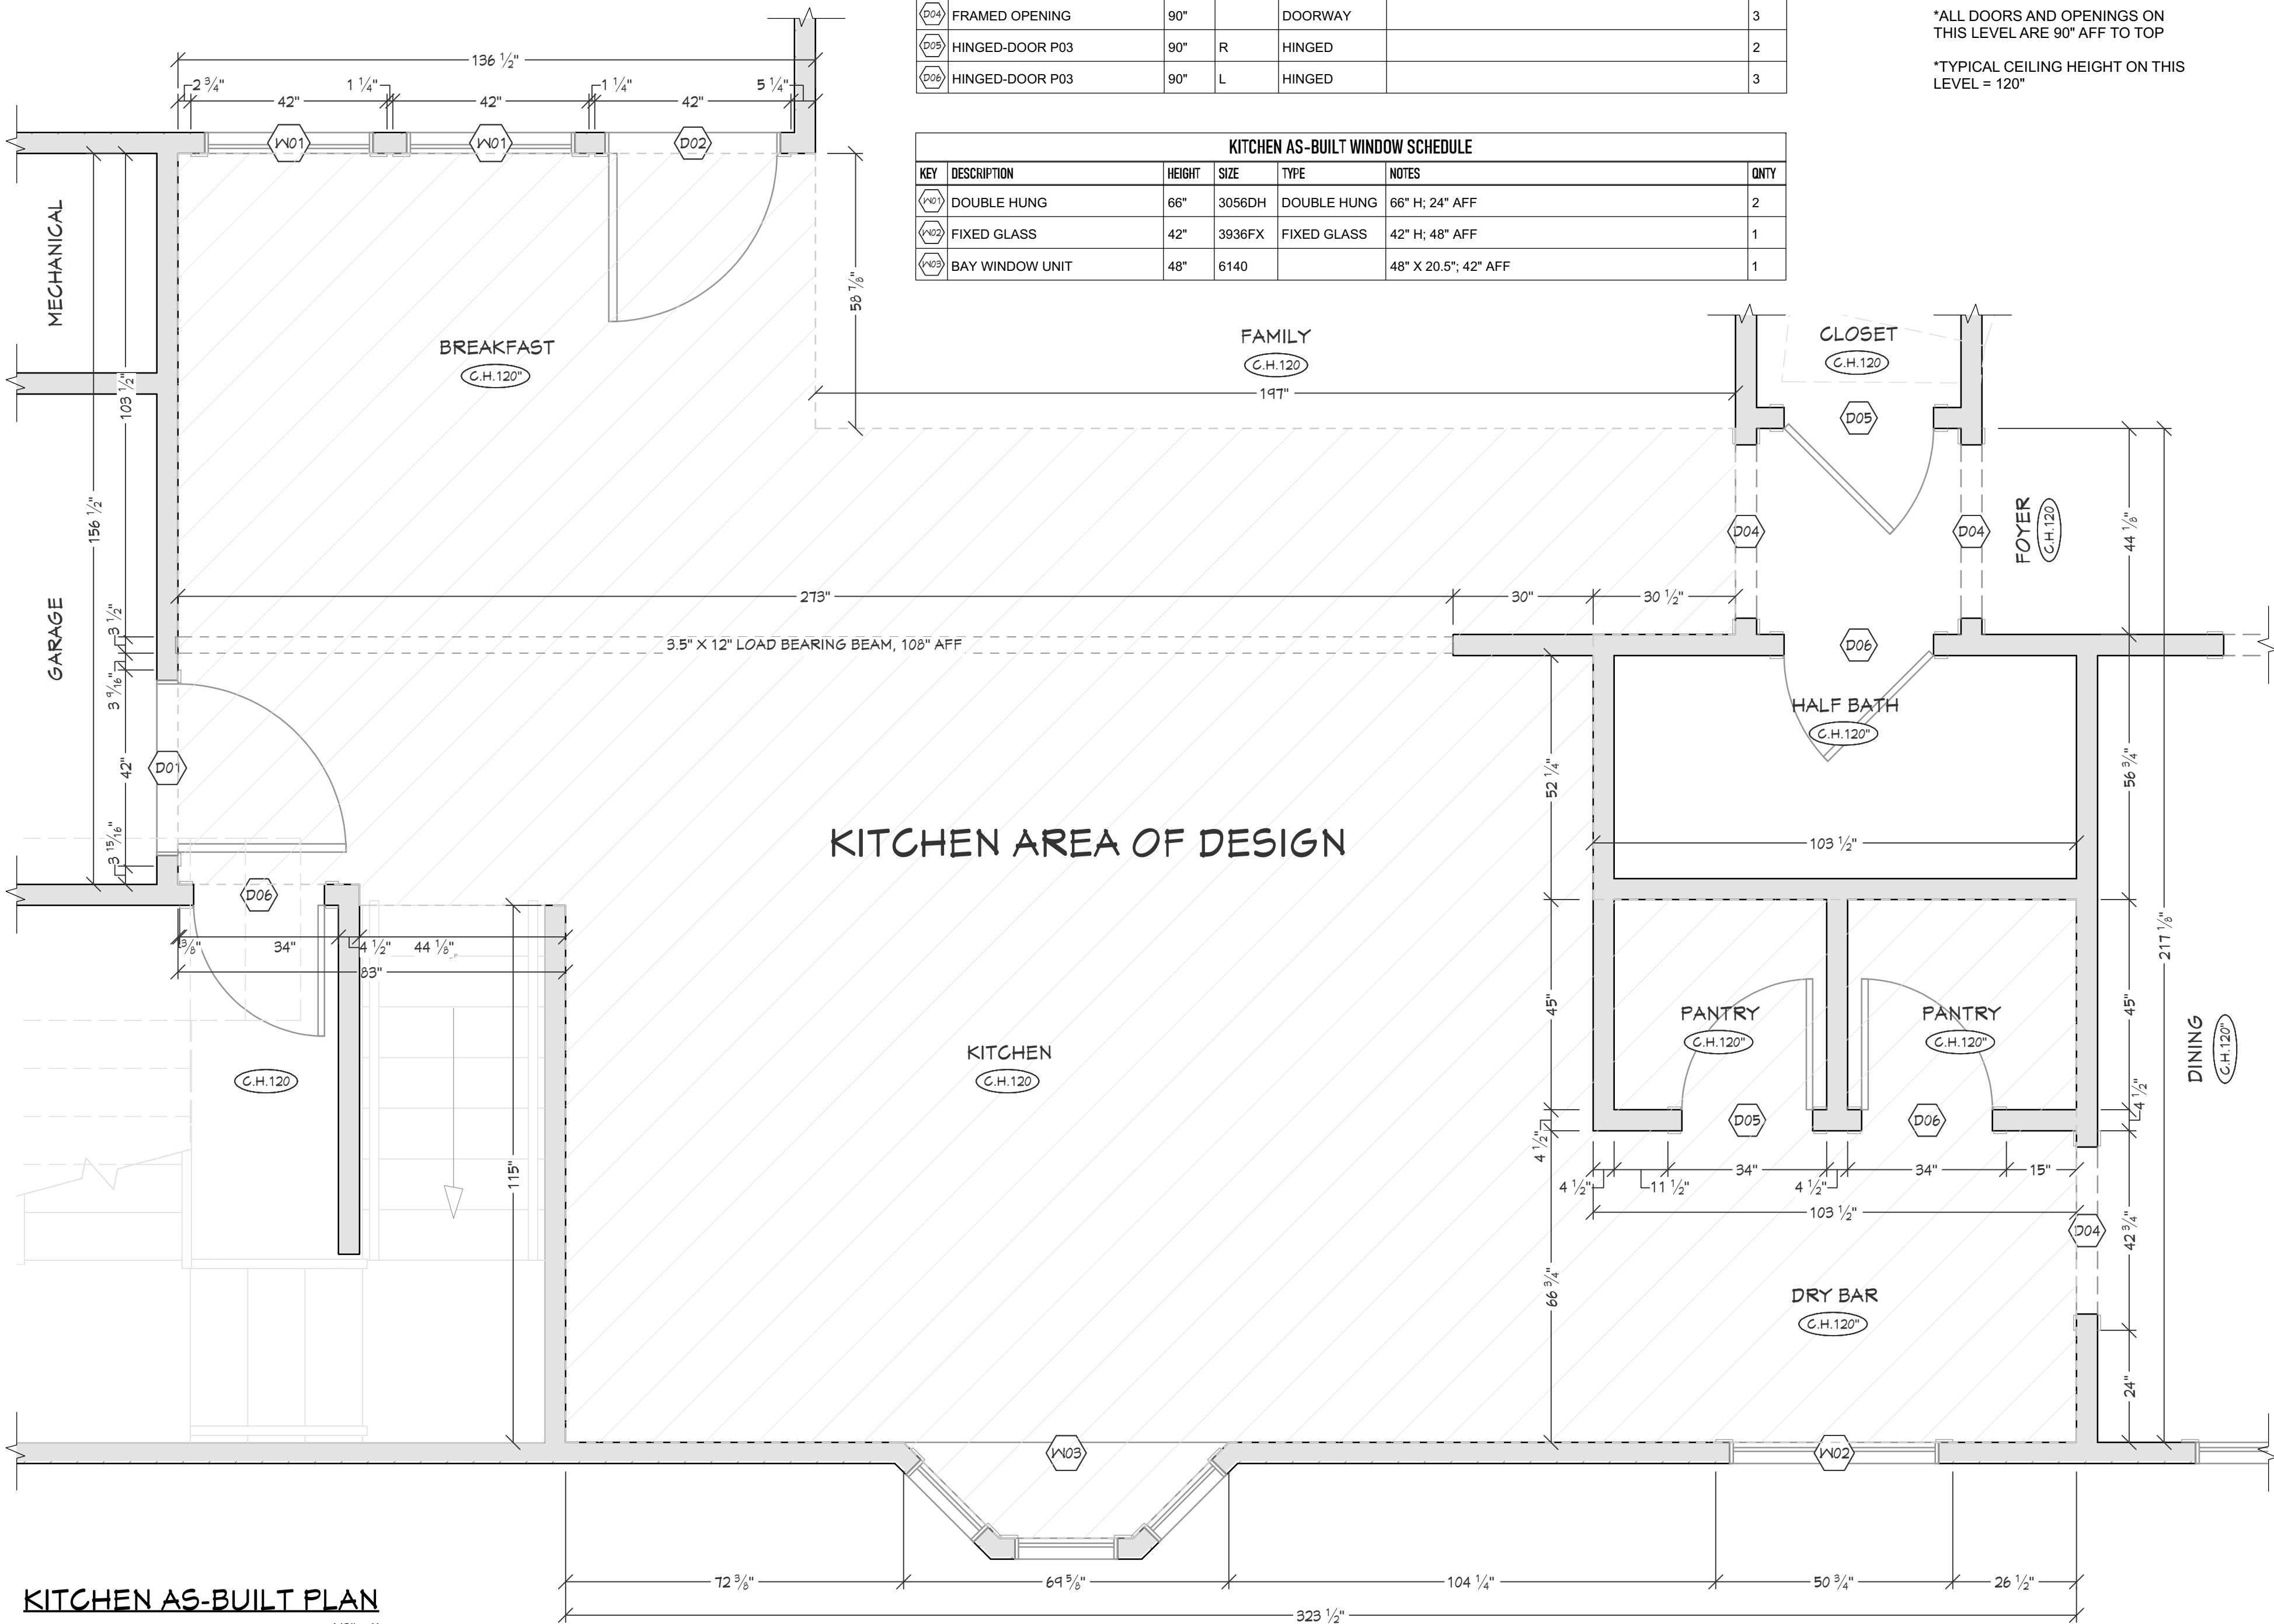

KITCHEN AS-BUILT PLAN
1/2" : 1'

BATH AS-BUILT DOOR SCHEDULE						
KEY	DESCRIPTION	HEIGHT	HINGE SIDE	TYPE	NOTES	QNTY
D01	HINGED-DOOR P03	84"	L	HINGED		1
D02	HINGED-DOOR P03	84"	R	HINGED		4
D03	SHOWER-GLASS SLAB	80"	L	SHOWER		1


BATH AS-BUILT WINDOW SCHEDULE						
KEY	DESCRIPTION	HEIGHT	SIZE	TYPE	NOTES	QNTY
W01	DOUBLE HUNG	36"	2030DH	DOUBLE HUNG	36" H; 48" AFF	2
W02	DOUBLE CASEMENT-LHL/RHR	48"	5140DC	DOUBLE CASEMENT	48" H; 36" AFF	1

NOTES


AREA OF DESIGN

*ALL DOORS AND OPENINGS ON THIS LEVEL ARE 84" AFF TO TOP


*TYPICAL CEILING HEIGHT ON THIS LEVEL = 108"

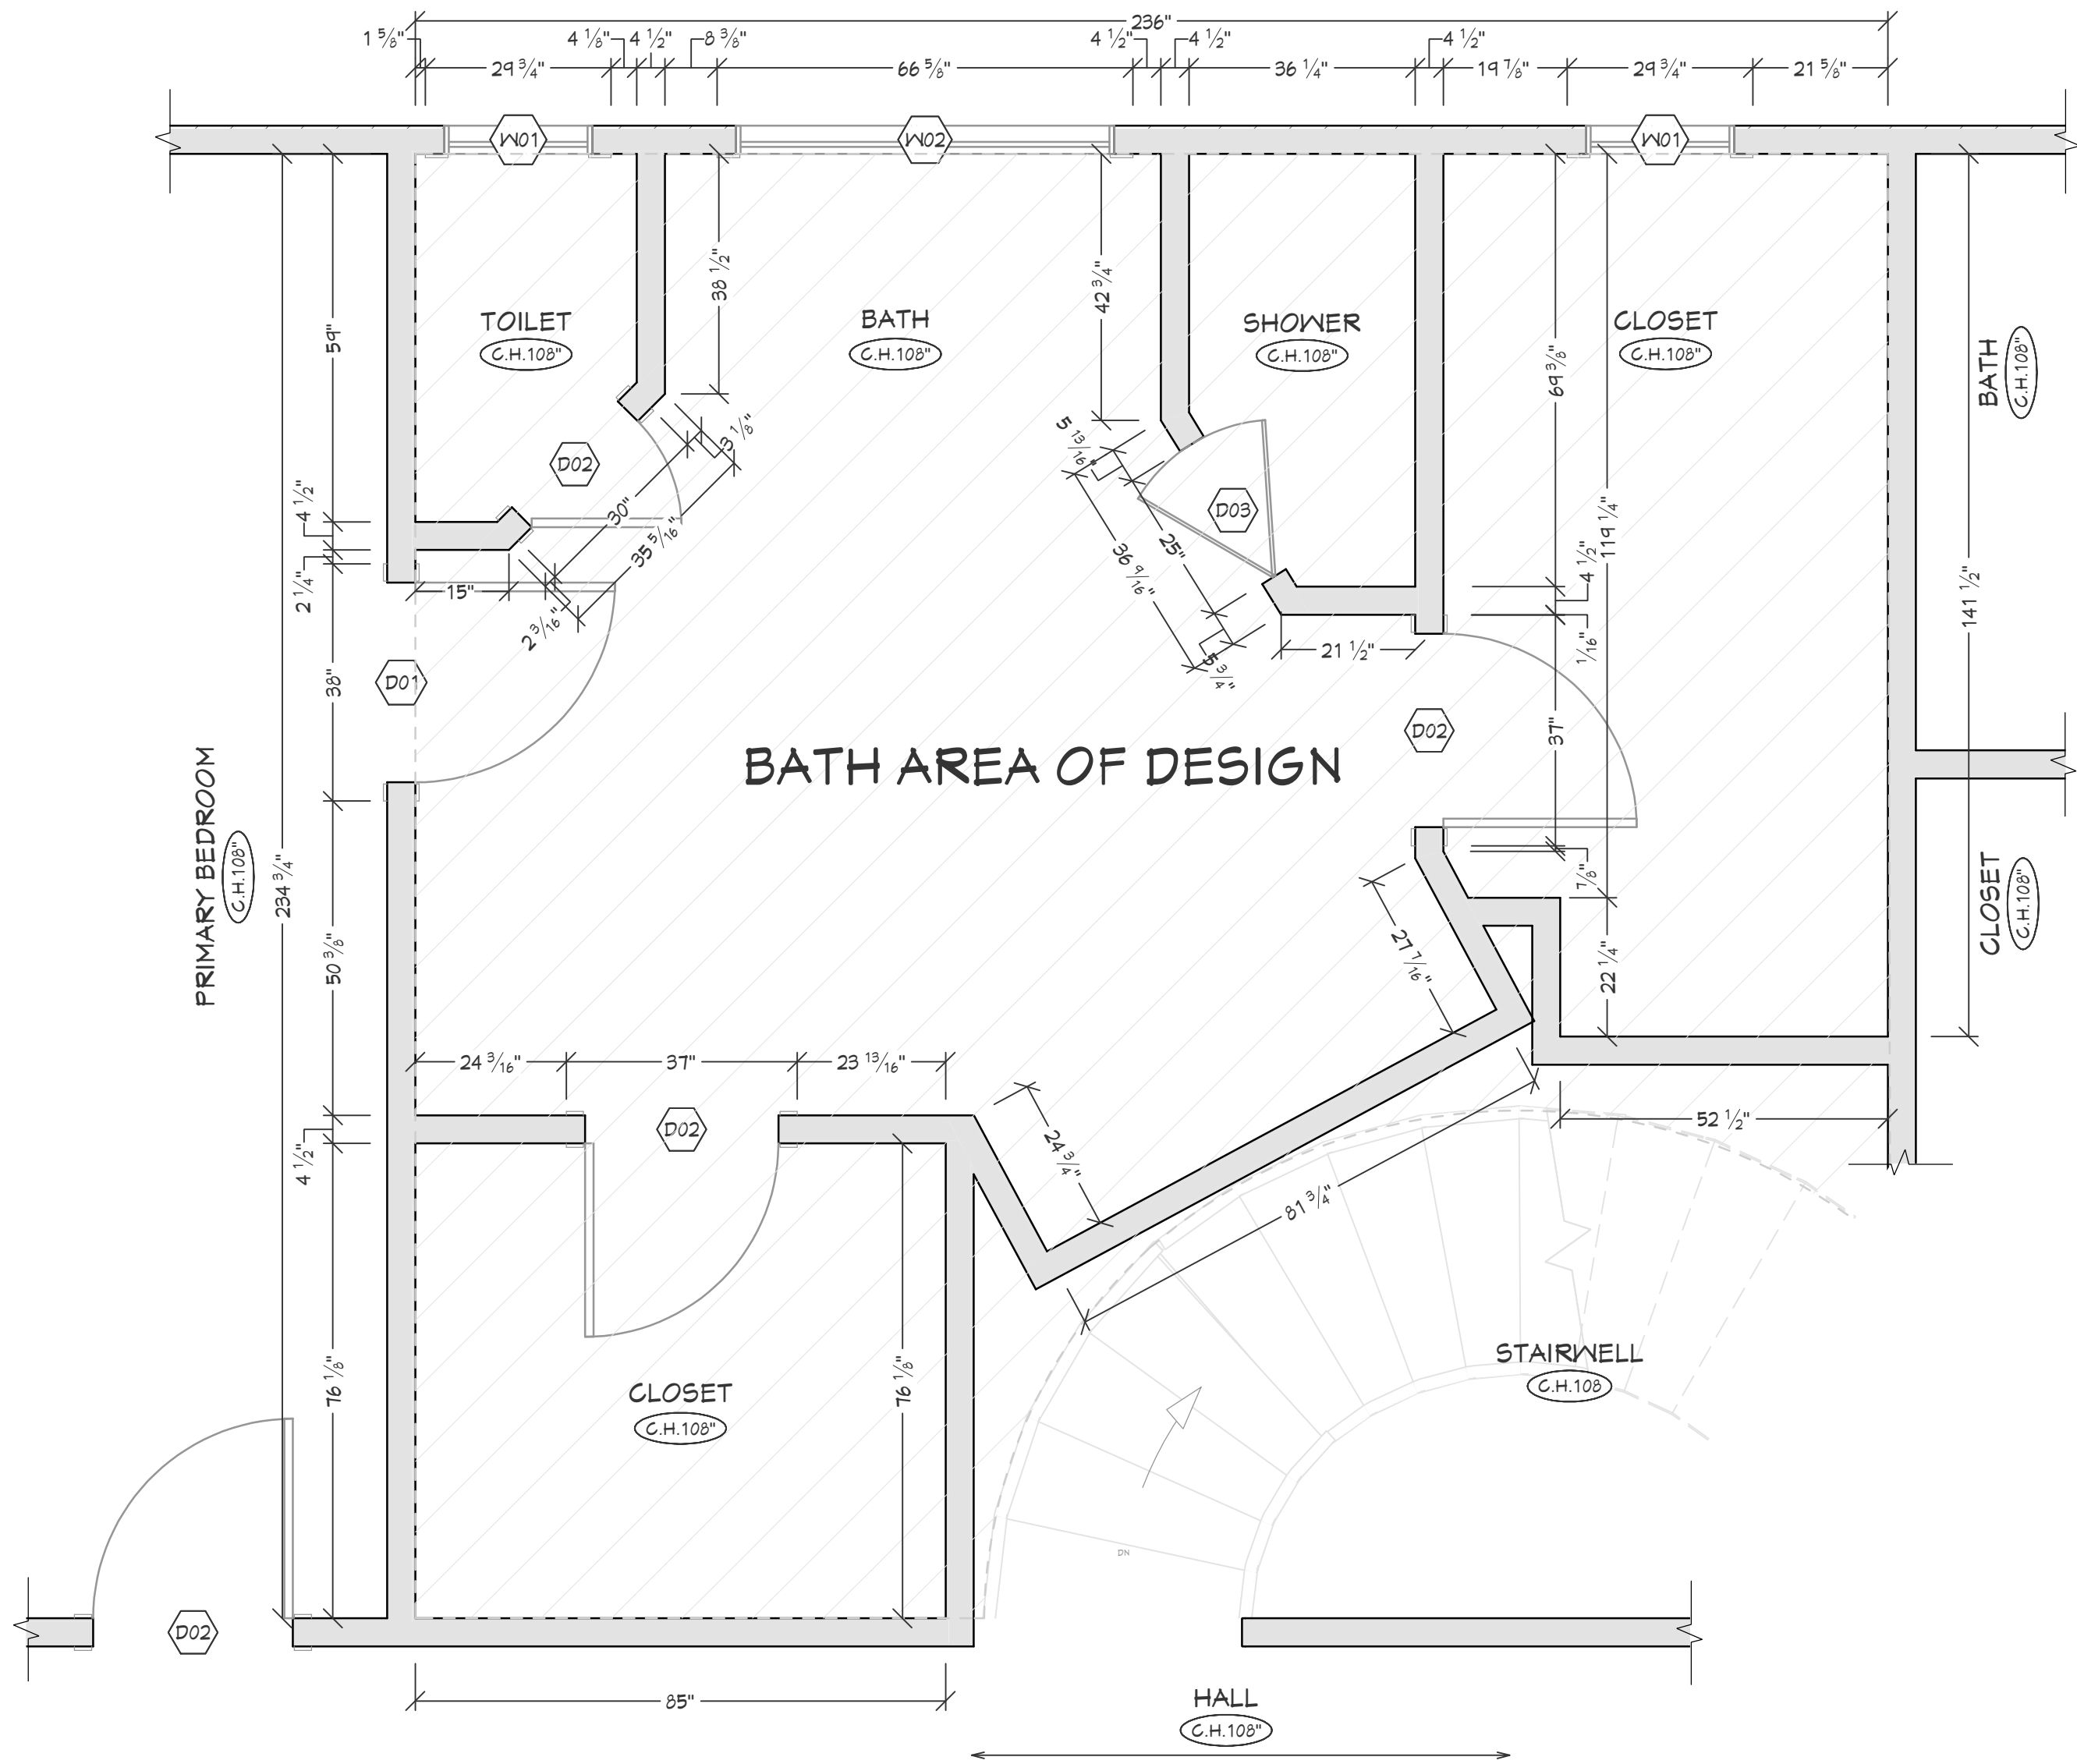

BATH AS-BUILT PLAN
1/2" = 1'

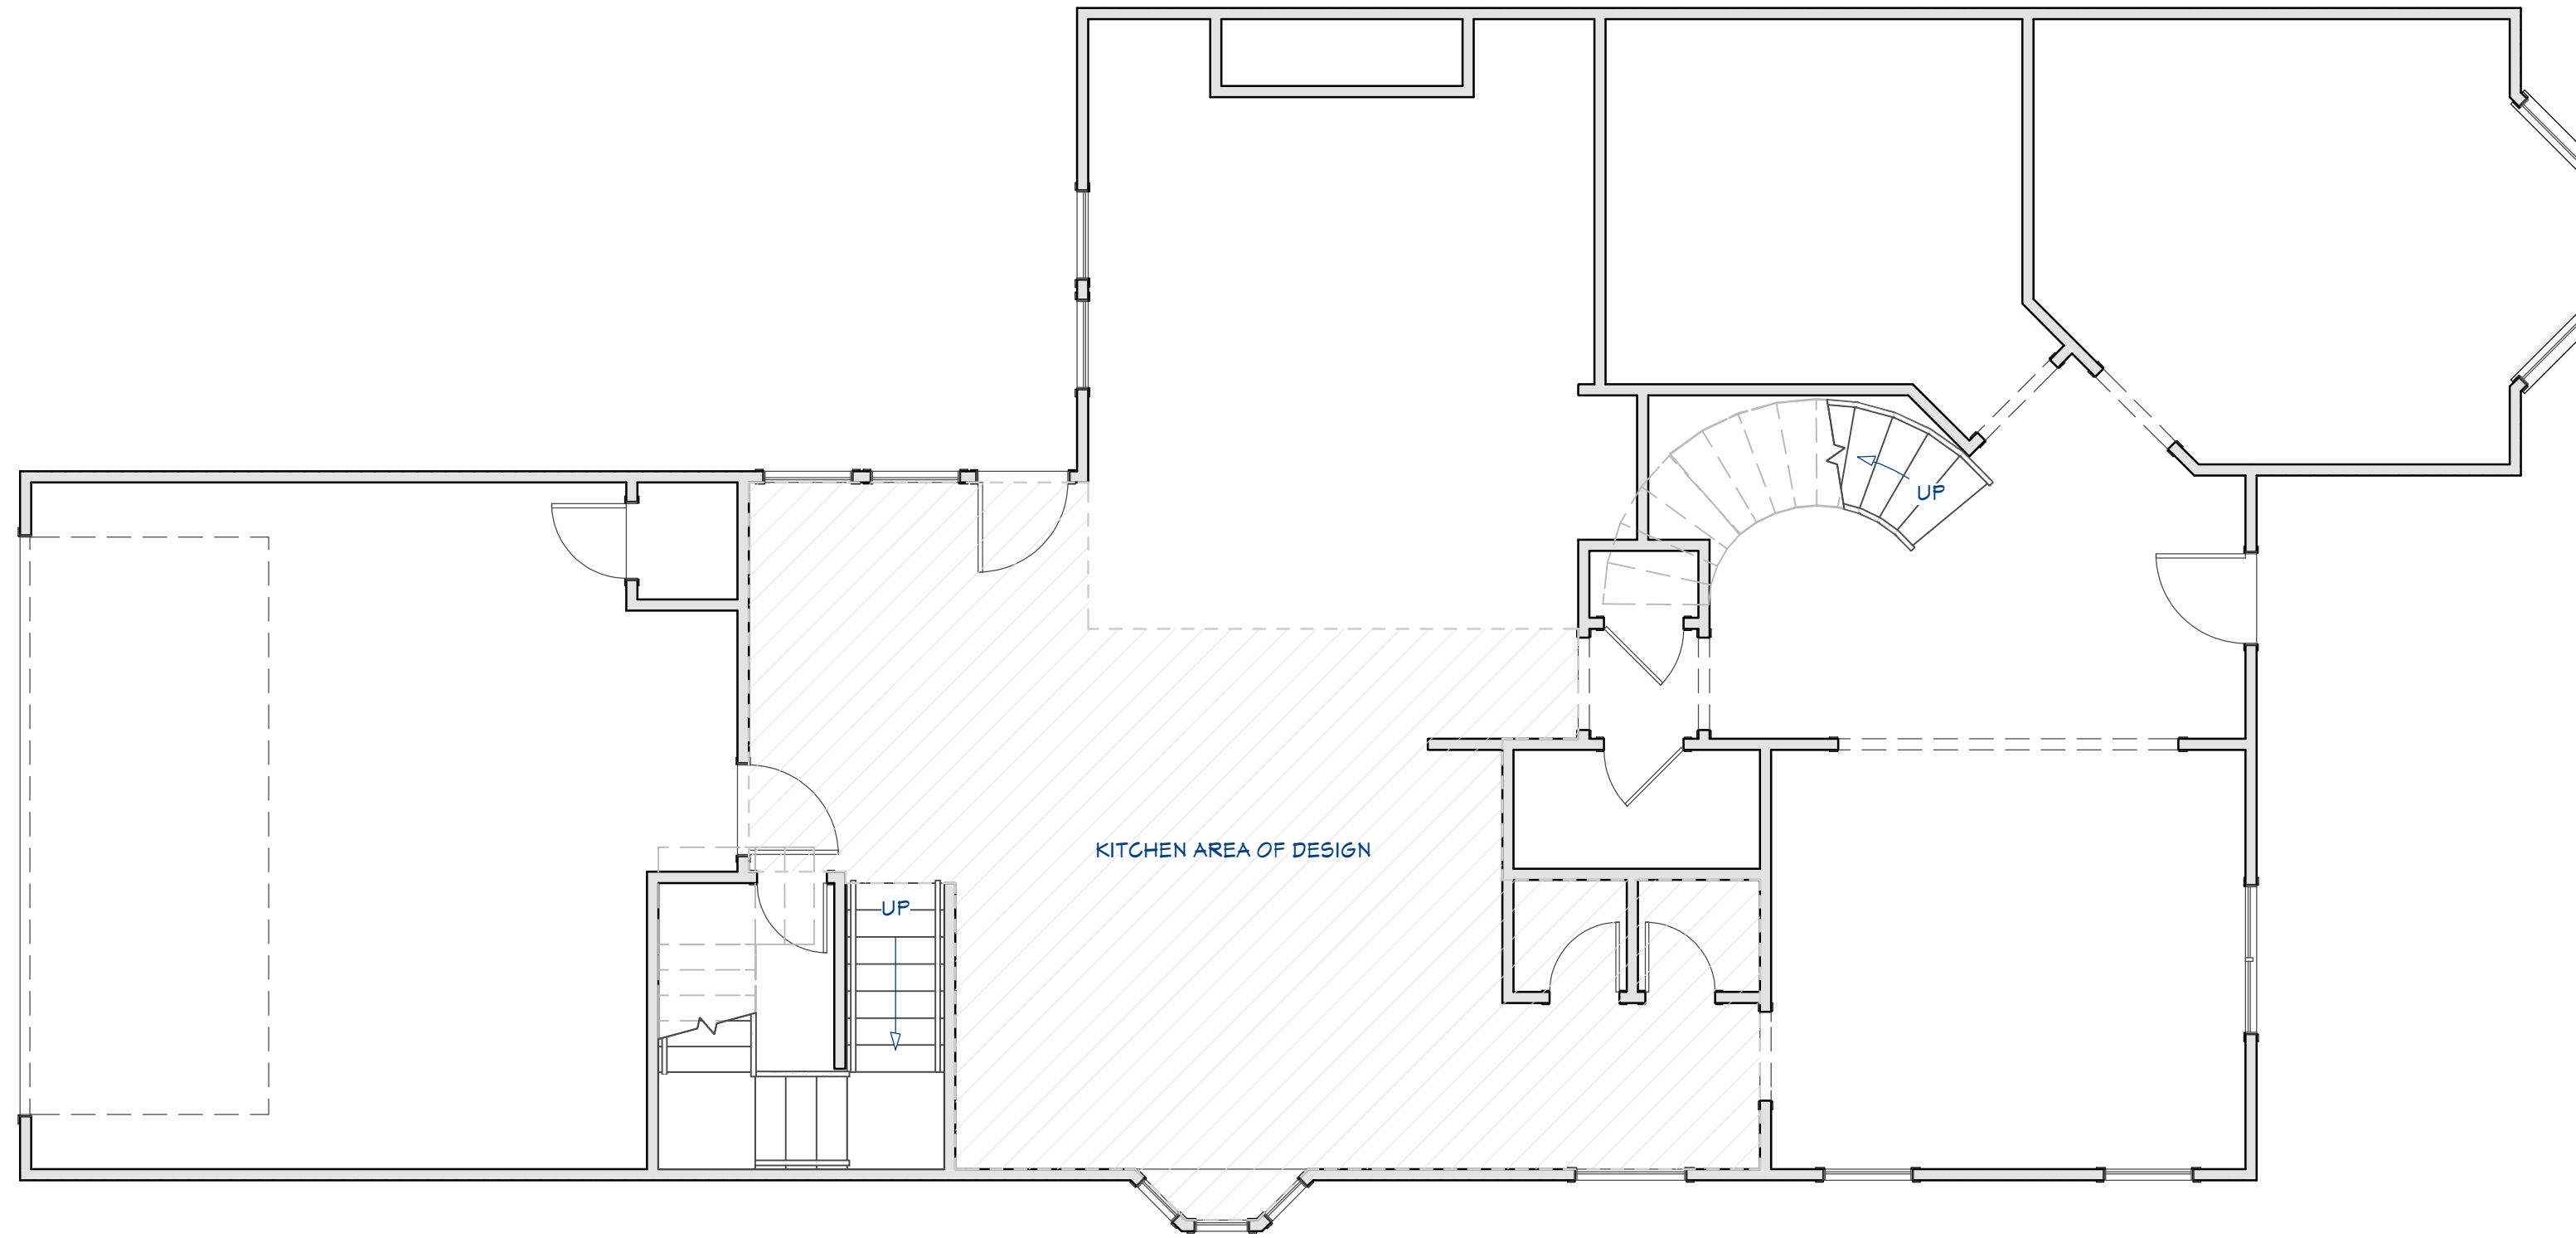

MAIN FLOOR PLAN
3/16" : 1'

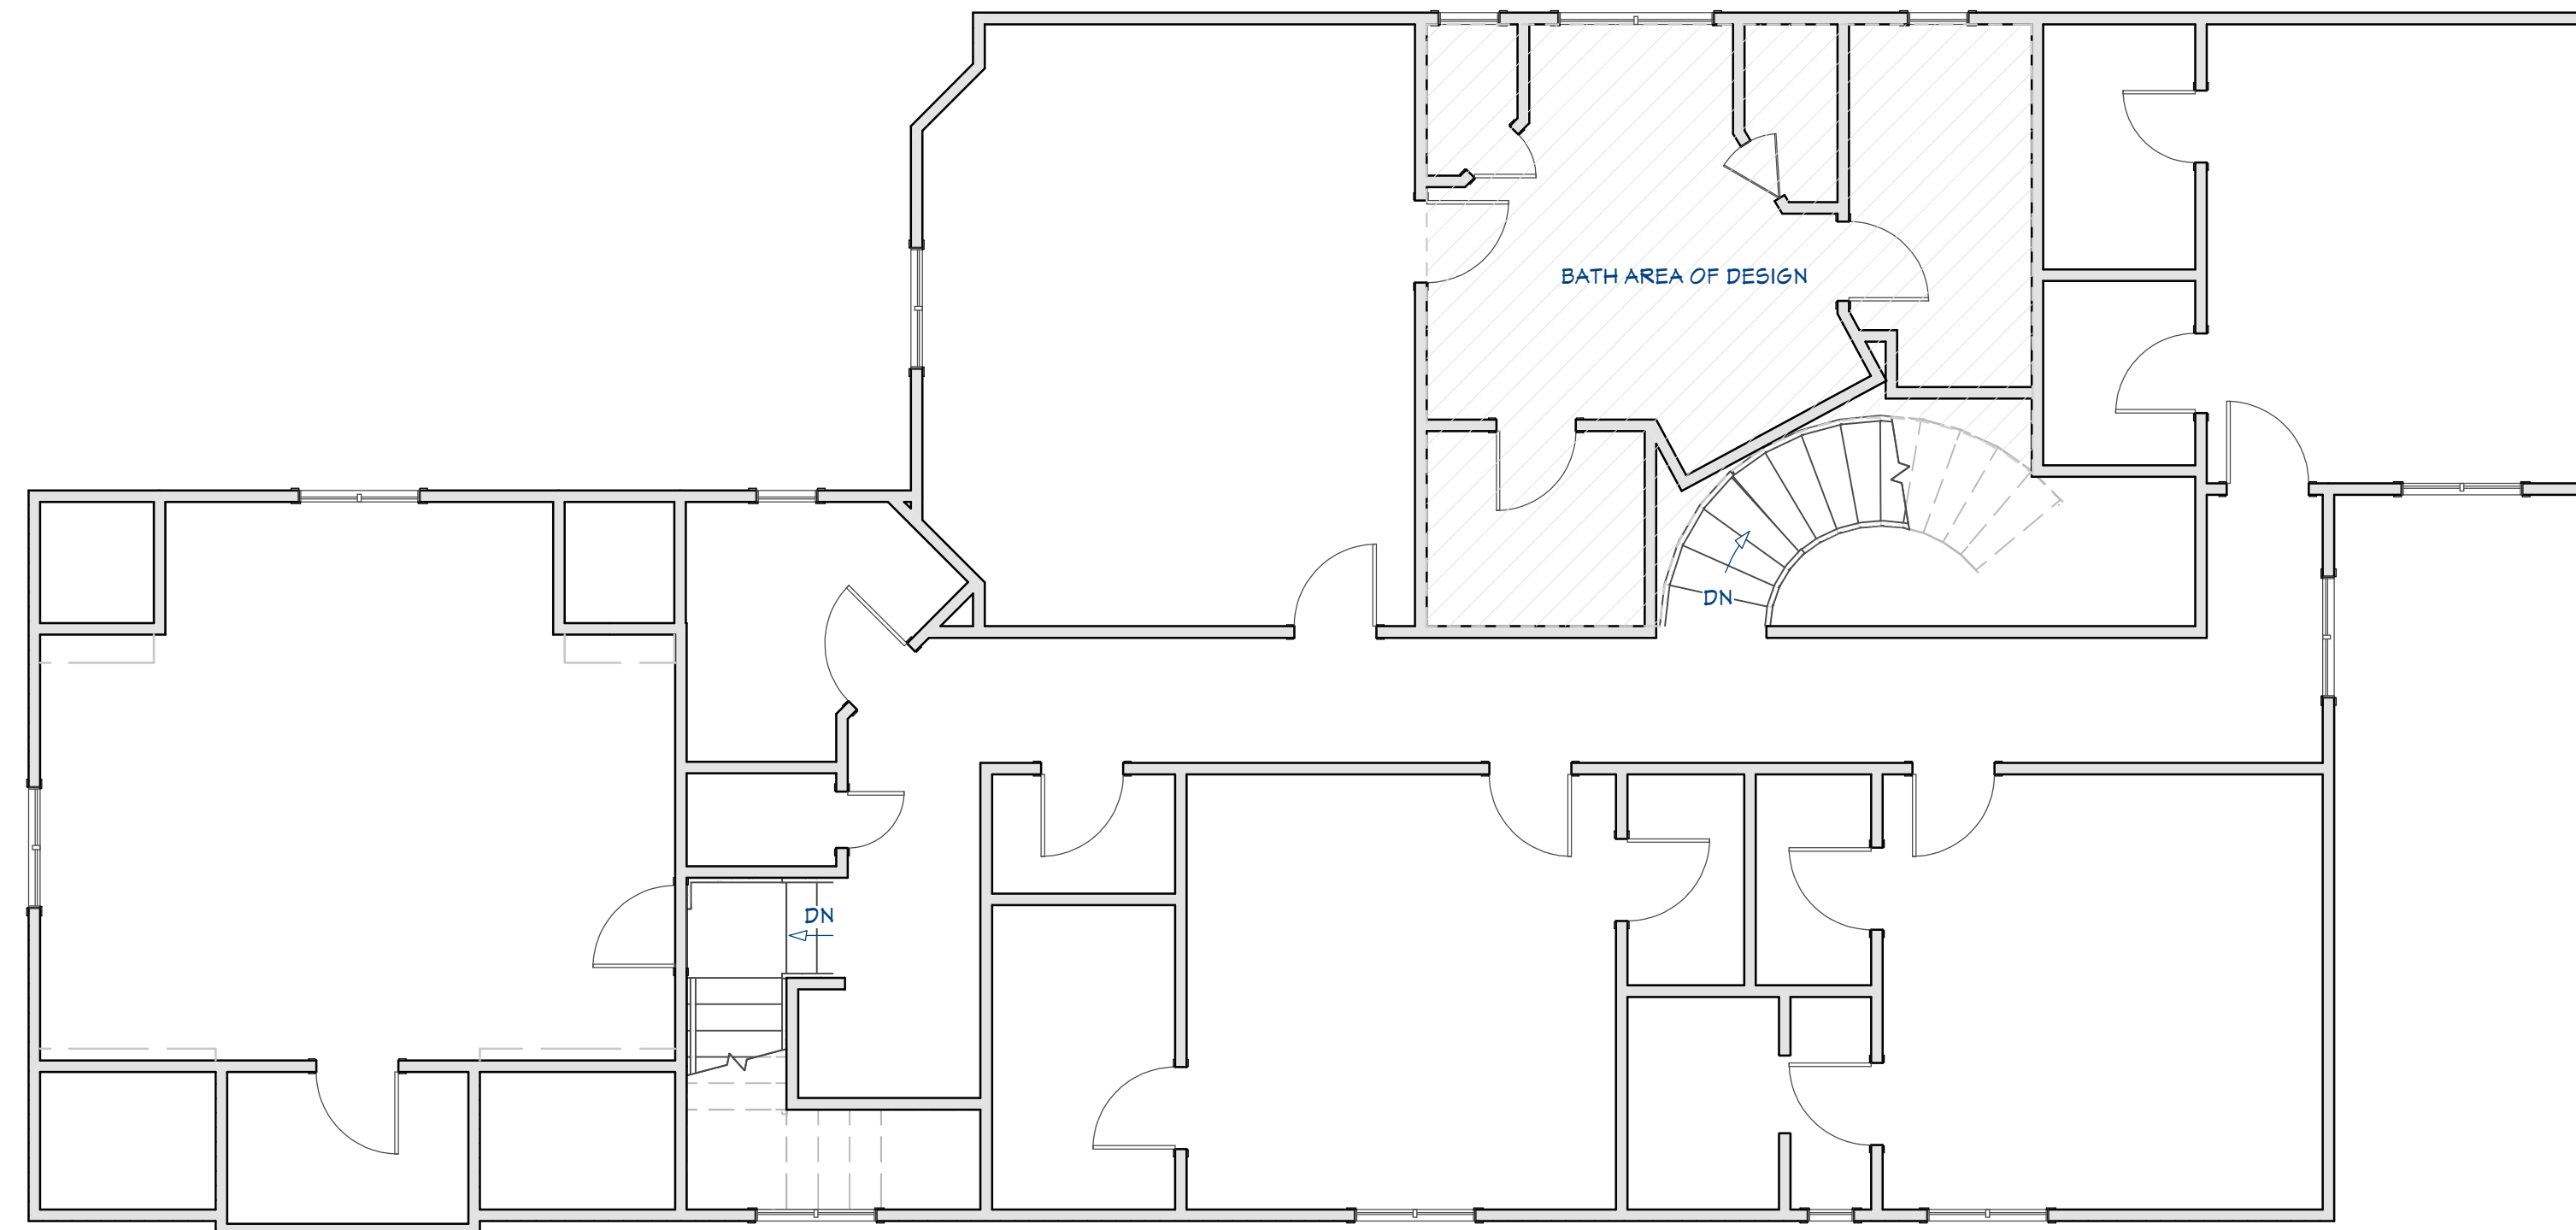

SECOND FLOOR PLAN
3/16" : 1'